


PLAN 733

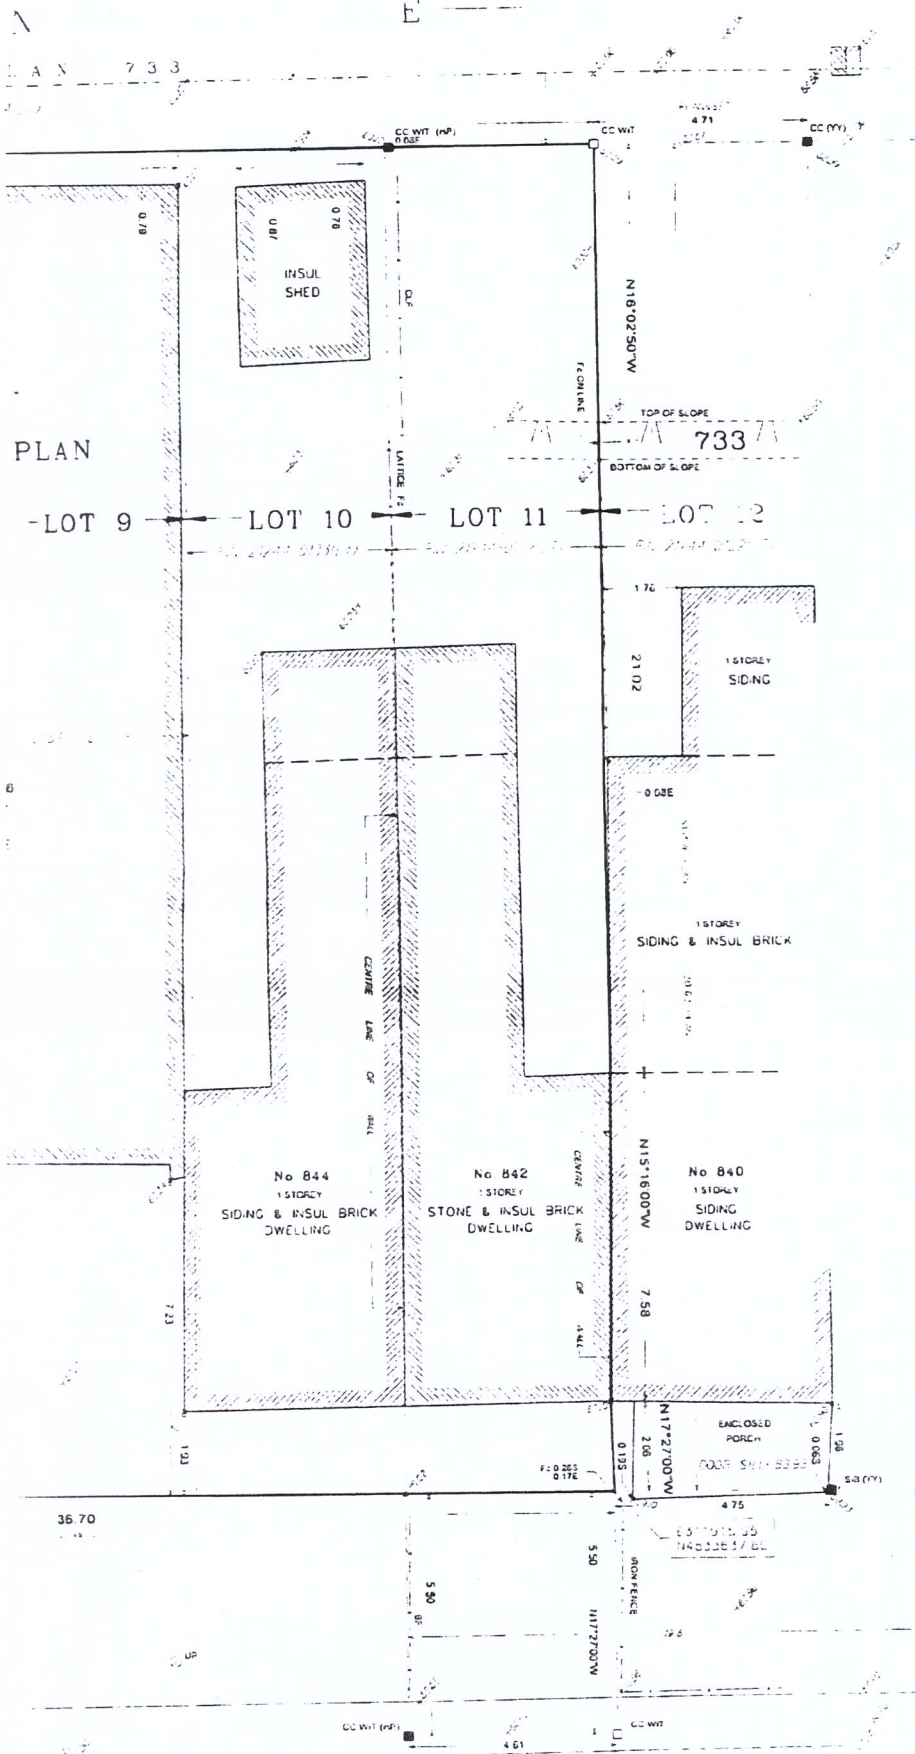

SCALE 1:1000
H. MILLER CORP

PART 2:
PREPARED FOR
LOCATION OF THE BUILDING
EAVES:
UTILITY BUILDINGS:
DECKS:
SWIMMING POOLS:
EXISTING FENCES:

EASEMENTS:
RIGHTS OF WAY:

LEGEND:

■	DENOTES	SUR
□	DENOTES	SUR
IB	DENOTES	IRON
SIB	DENOTES	ST
SSIB	DENOTES	SH
CC	DENOTES	CC
CP	DENOTES	CC
WIT	DENOTES	WIT
O/U	DENOTES	OR
N	DENOTES	NO
S	DENOTES	SO
L	DENOTES	LA
W	DENOTES	WE
Fc	DENOTES	FE
CLF	DENOTES	CH
BF	DENOTES	BO
P & W	DENOTES	PO
PLAN	DENOTES	RE
DEED	DENOTES	IN
CTS	DENOTES	CI
TY	DENOTES	YO
FFF	DENOTES	FI
FH	DENOTES	FI
UP	DENOTES	UT
MR	DENOTES	MA
■	DENOTES	CA

METRIC:
DISTANCES SHOWN ON T
CONVERTED TO FEET BY

BEARING NOTE:
BEARINGS HEREON ARE C
HORIZONTAL CONTROL ME
N48°35'54.645) AND 020.
AND ARE REFERRED TO
WEST LONGITUDE, ZONE

ELEVATIONS NOT
ELEVATIONS SHOWN HER
FROM THE CITY OF TOR
ELEVATION - 88 236m

PERM

SURVEYOR'S CERT
I CERTIFY THAT



Toronto Building

1st Floor West Tower
100 Queen St. W.
Toronto, ON M5H 2N2

Victor Araujo
Manager, Plan Review, Toronto
and East York District

Tel: 416 392 0480
Fax: 416 392 0721

September 14, 2011

TO: Councillor Mike Layton, 2nd Floor, Suite C47, Toronto City Hall
Parks, Forestry & Recreation – Urban Forestry – Tree Protection & Plan Review, 50 Booth
Av., 2nd Flr. (Attention: Mark Ventresca)
Urban Forestry, Ravine Planning and Protection, 18 Dyas Road, Main Floor (Attention: Tara
Bobie, Ravine South District Planner)
Mary L. Macdonald, Acting Manager, Heritage Preservation Services, Policy & Research,
2nd Floor, Suite A18, Toronto City Hall
Yasmina Shamji, Support Assistant, Heritage Preservation Services, Policy & Research, 2nd
Floor, Suite A18, Toronto City Hall

RE: 842 RICHMOND STREET WEST
RESIDENTIAL DEMOLITION APPLICATION NO. 11 272806 DEM

In accordance with the procedures adopted by Toronto City Council respecting the processing of residential demolition applications, attached is a copy of an application for demolition.

Residential Demolition Control under Article II, Demolition Control, of the Municipal Code Chapter 363 as amended by By-law No. 1009-2006, directs the Chief Building Official, Toronto Building, to issue demolition permits unless an objection is received. Note that a building permit for a replacement building has not been applied for as of the date of this memorandum.

The demolition permit application and report will be forwarded to Community Council for consideration.

Victor Araujo
Manager, Plan Review
Toronto & East York District
/mf

Attach.

From: Yasmina Shamji
To: Araujo, Victor; Barbini, Armando; Tam, Wade
CC: Demos; Flammia, Mary
Date: 09/16/2011 11:39 AM
Subject: Demolition Applications - TEY

Hello

Heritage Preservation Services has reviewed the following demolition applications. None of these properties are included on the City's Inventory of Heritage Properties:

0041 Orley Av
0043 Doris Dr
0193 Forest Hill Rd '
0844 Richmond St W
0842 Richmond St W

thank you


Yasmina Shamji
Support Assistant
Heritage Preservation Services
Policy & Research, City Planning
100 Queen Street West
Suite A18 - 2nd Floor
Toronto, ON M5H 2N2
tel: 416.392.1975
fax: 416.392.1973

Google maps

Address **842 Richmond St W**
Toronto, ON M6J 1C9, Canada

Save trees. Go green!

Download Google Maps on your
phone at google.com/gmm

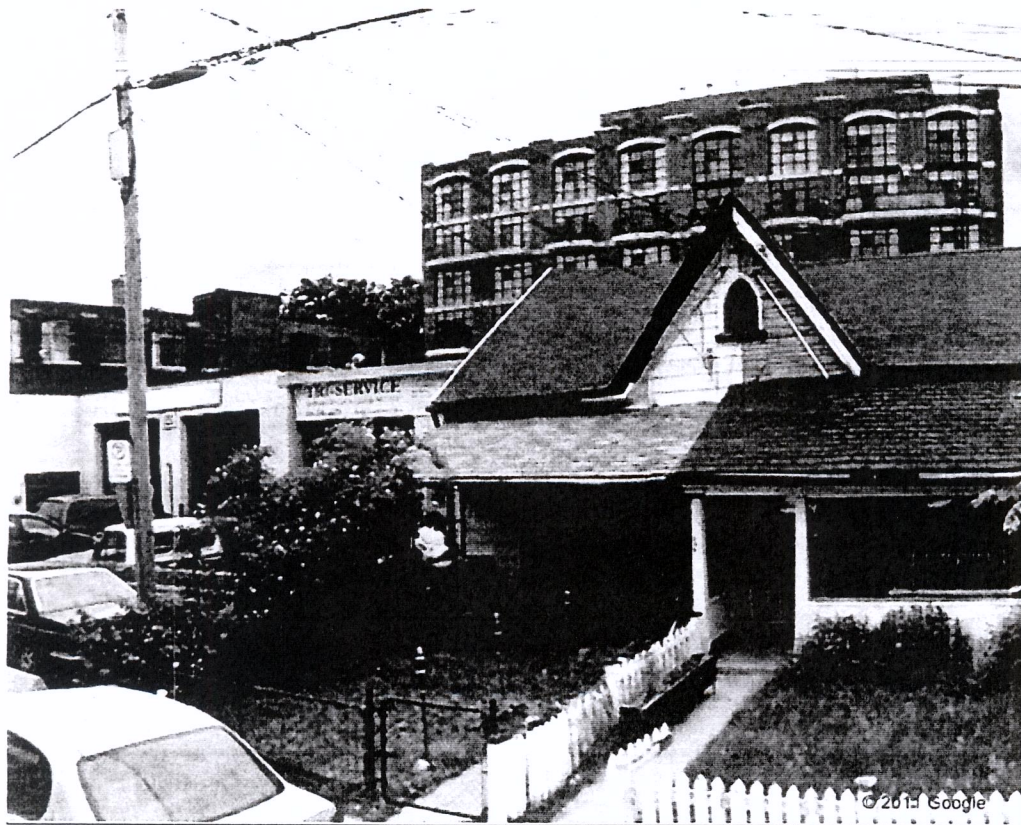

↑
#842

↑
#842