


**Attachment 2 - Yonge-Dundas Square Revitalization Plan, Kramer Design  
Associates**

Stage Screen Right

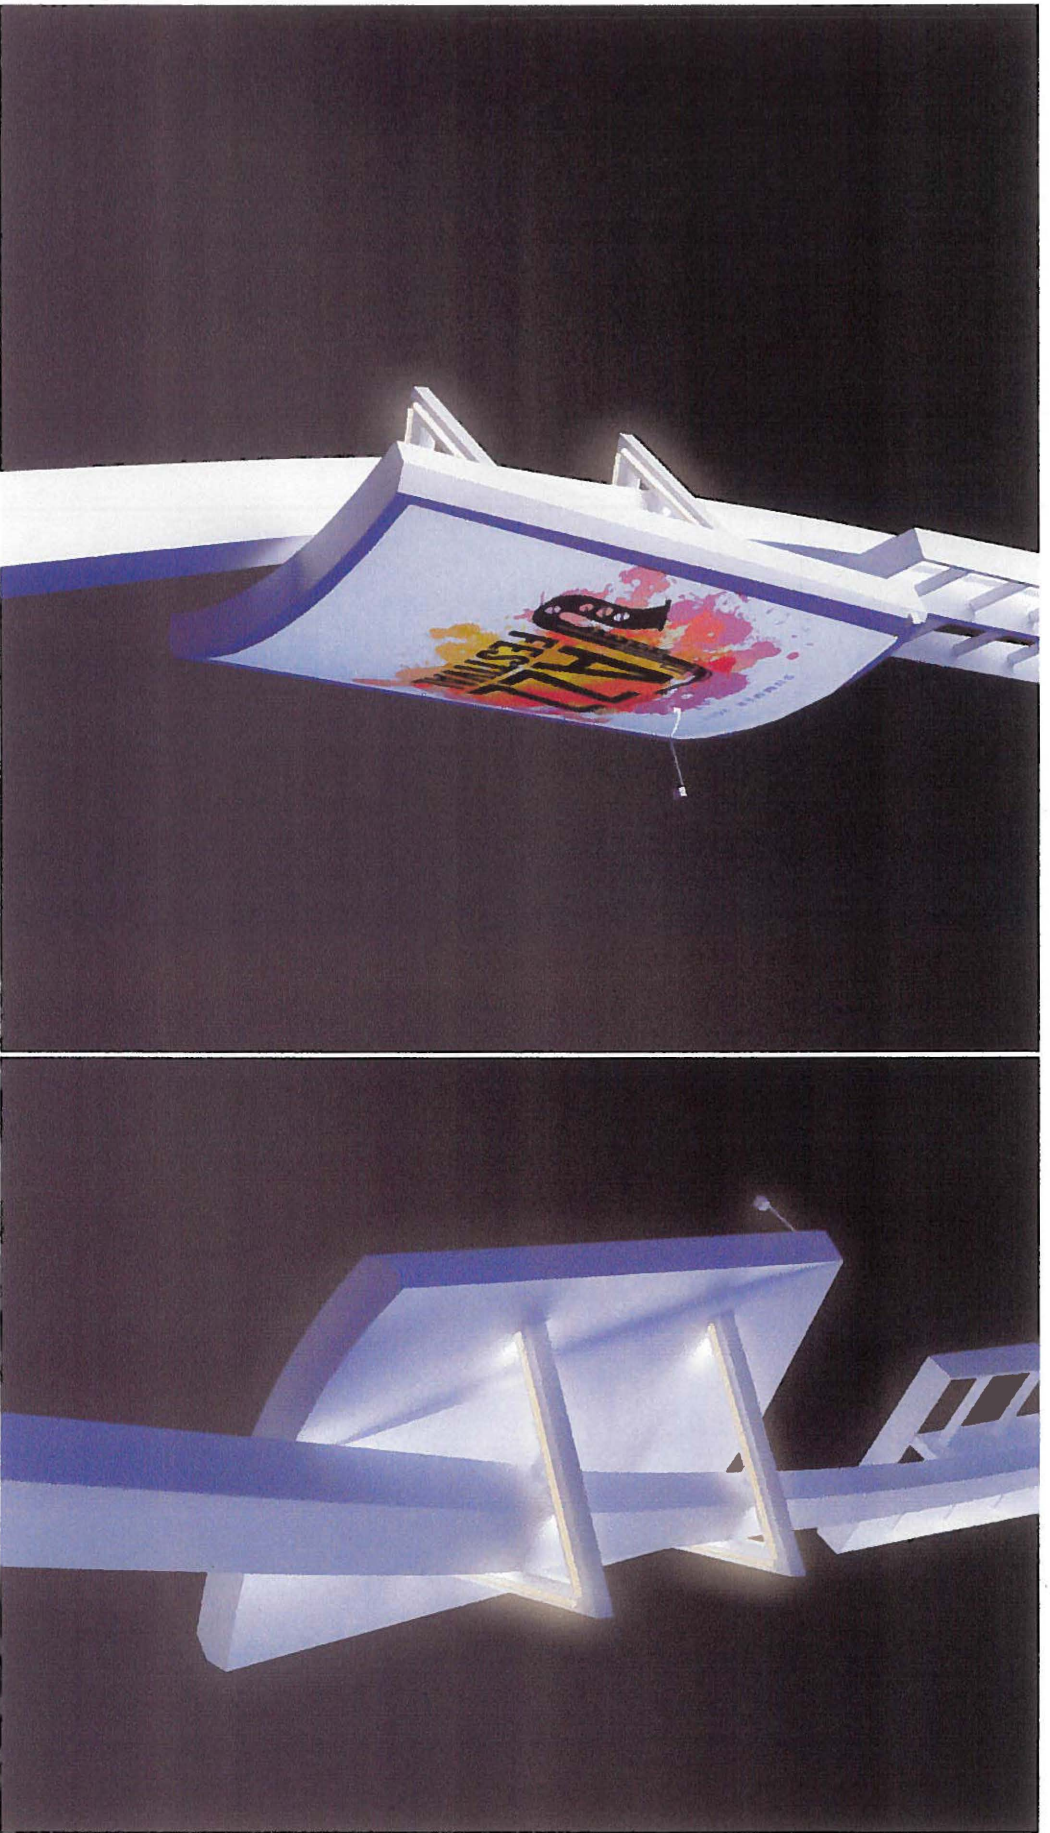

Digital Light Poles



YONGE - DUNDAS SQ.


Yonge - Dundas Square Revitalization Plan  
REF. No. 3119-12 2159

Digital Light Poles

# Yonge - Dundas Square (View Travelling North)



Yonge - Dundas Square (View Travelling South)

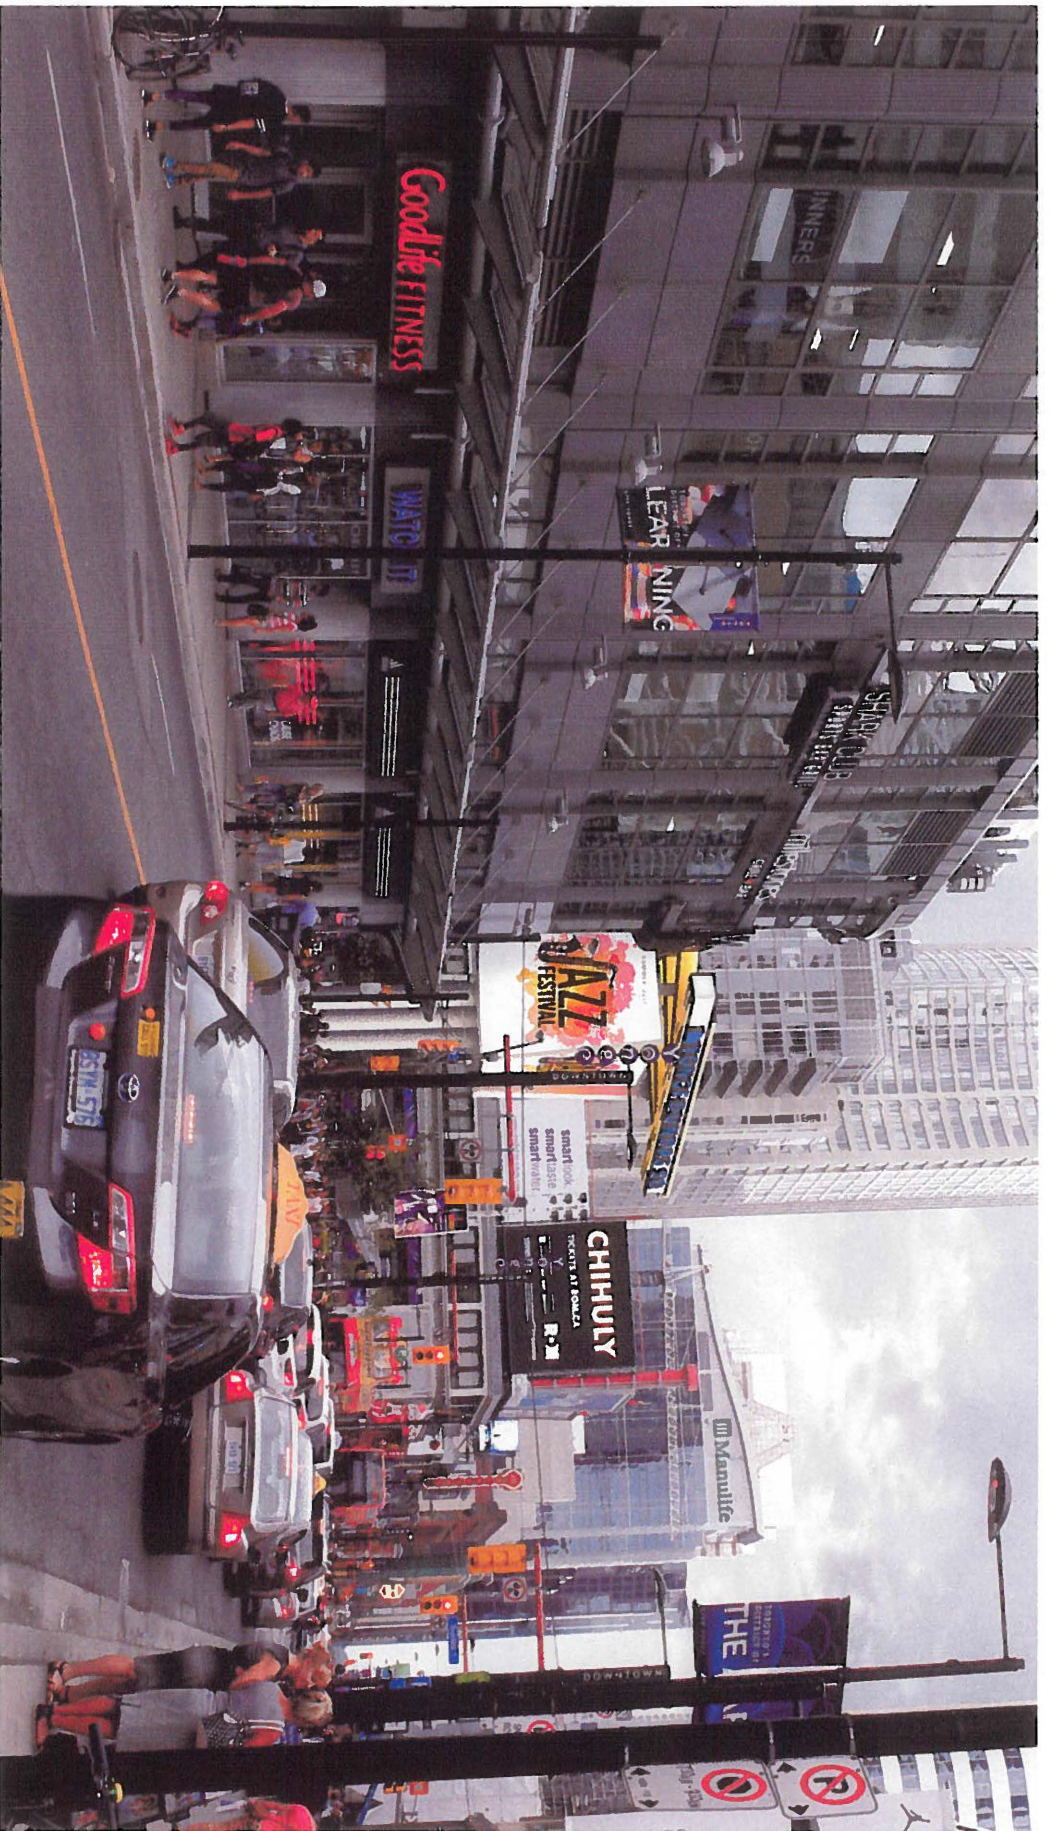

Yonge - Dundas Square (View Travelling East)



Yonge - Dundas Square (View Travelling West)



YONGE-DUNDAS SQ.

Yonge - Dundas Square Revitalization Plan  
(RFP No. 9119-15-27153)

Yonge - Dundas Square (View Travelling West)

Yonge - Dundas Square (View from Victoria St.)





Yonge - Dundas Square (View from O'Keefe Ln.)



YONGE-DUNDAS SQ.

Yonge - Dundas Square Revitalization Plan  
RFP No. 2112-15-7159

Yonge - Dundas Square (View from O'Keefe Ln.)



Technical Design

KDA

RED LINES DENOTE EXISTING CANOPY AND SIGNAGE TO BE REMOVED

NORTHWEST GATEWAY DWG. W2.1 & W2.1a

YONGE STREET

DUNDAS STREET

STAGE SCREEN LEFT DWG. W2.3

NORTHEAST GATEWAY DWG. W2.2

DIGITAL LIGHT POLES DWG. W2.5


STAGE SCREEN RIGHT DWG. W2.4

DIGITAL LIGHT POLES DWG. W2.5

DIGITAL LIGHT POLES DWG. W2.5


DUNDAS SQUARE STREET

1 Site Plan  
W2.0 Scale: 1:300

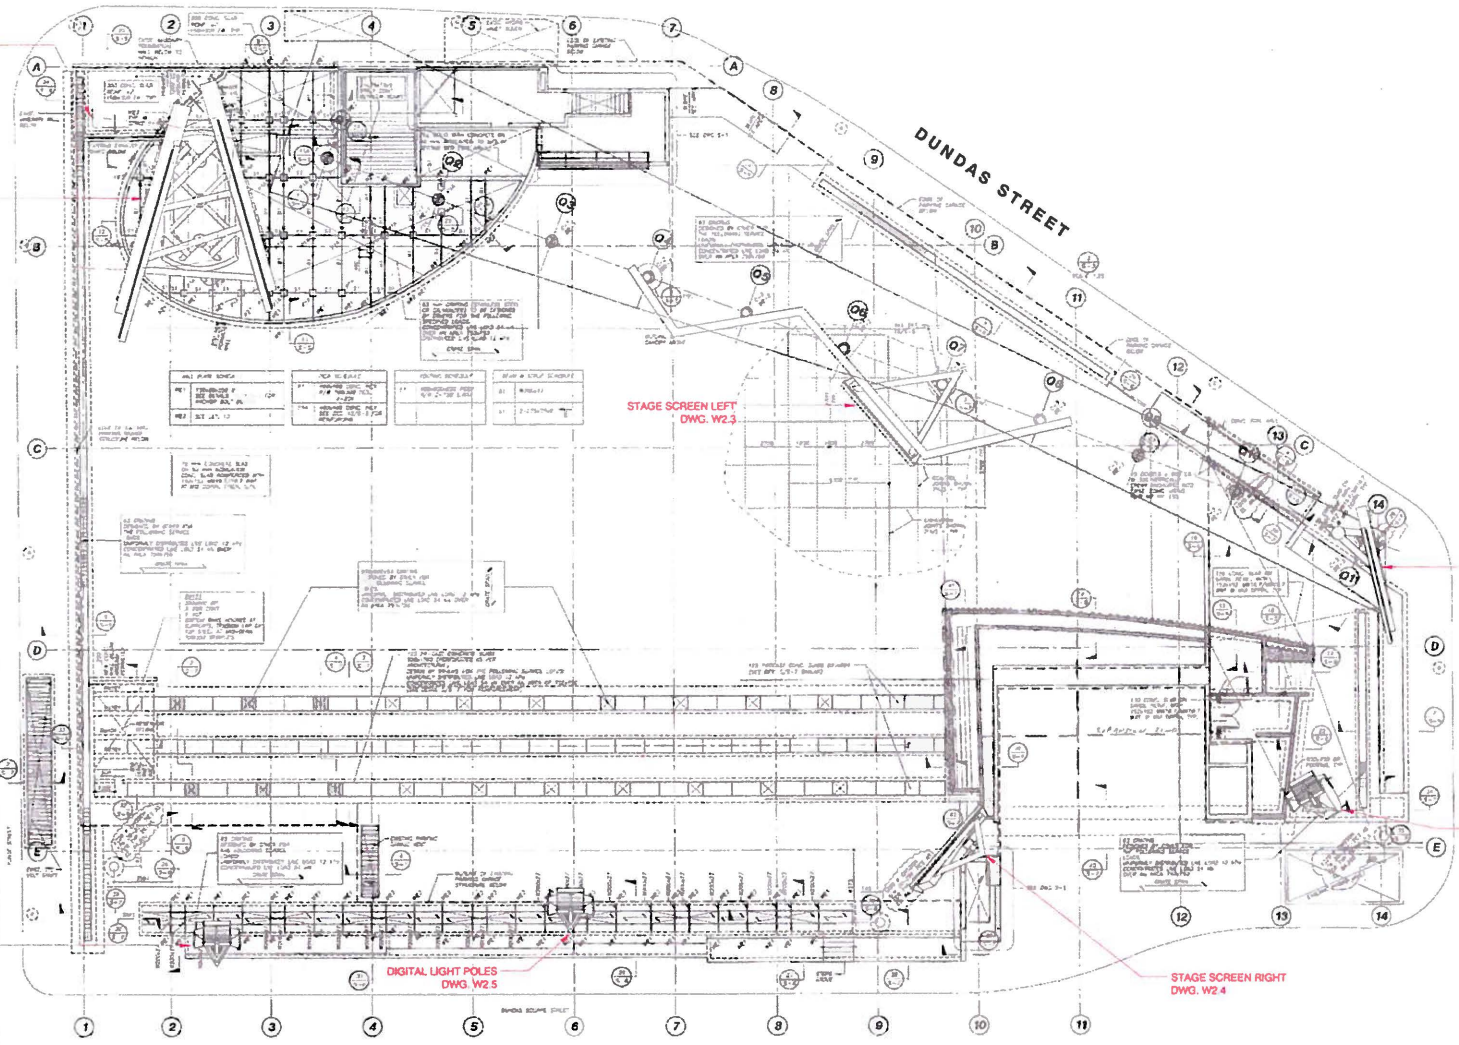


Kramer Tel: 416.921.1078  
Design Fax: 416.921.8934  
Associates www.kramer-design.com

CLIENT	Yonge-Dundas Square	PROJECT	Yonge-Dundas Square Revitalization	DATE	Master Plan Submission November 3, 2016	TITLE	Site Plan	DWG No	W2.0
<small>These documents are not to be copied. The design and documents remain the property of KDA and are protected by law. They may not be altered, copied, or reproduced without expressed written consent from KDA. All documents to be returned to KDA at completion of each. Contractor to site verify all details and dimensions and report any and all discrepancies to KDA before commencing work that related portion of the work. Only signed, sealed and stamped documents are to be used for construction purposes.</small>								APPROVAL	

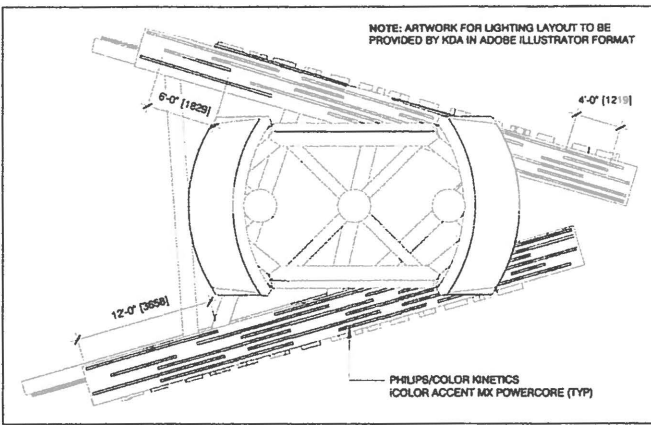


**NOTE:**

- ALL STRUCTURAL ELEMENTS ARE SUBJECT TO REVIEW AND APPROVAL AND ARE TO BE STAMPED BY A PROFESSIONAL ENGINEER LICENSED IN THE PROVINCE OF ONTARIO
- APPROPRIATE BARRIERS (NEOPRENE OR APPROVED EQUAL) TO PROVIDE BARRIER BETWEEN STEEL AND ALUMINUM ELEMENTS
- ALL STEEL IN CONFORMANCE WITH CSA G40.21 fy=300MPa MIN. STEEL TO BE HOT DIP GALVANIZED AND IF VISIBLE TO HAVE AAMA 2604 COMPLIANT POWDER COAT PAINTED FINISH UNLESS OTHERWISE SPECIFIED
- ALL ALUMINUM TO BE 6061-T6 [276MPa] WELDING TO CSA W47.2 W/ POWDER COAT PAINTED FINISH UNLESS OTHERWISE SPECIFIED
- NO VISIBLE FASTENERS
- ALL FASTENERS TO BE COUNTERSUNK STAINLESS STEEL UNLESS OTHERWISE SPECIFIED
- ALL STAINLESS STEEL TO BE GRADE 316

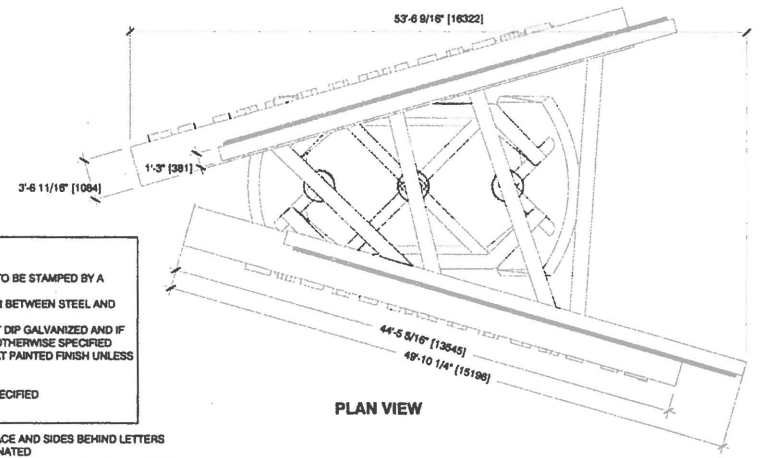


PLAN VIEW


2 Bottom View  
W2.1 Scale: 3/32" = 1'-0"

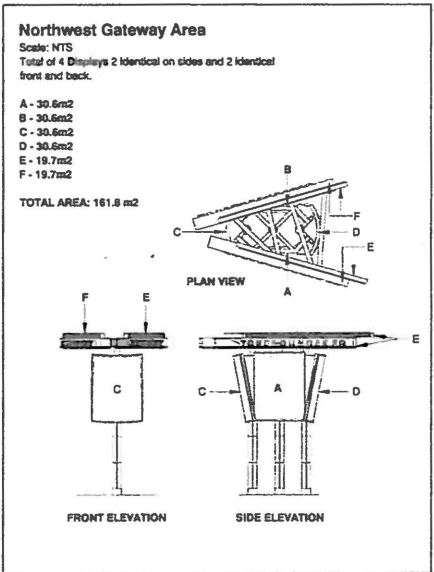

3 Digital Display Area  
W2.1 Scale: 3/32" = 1'-0"

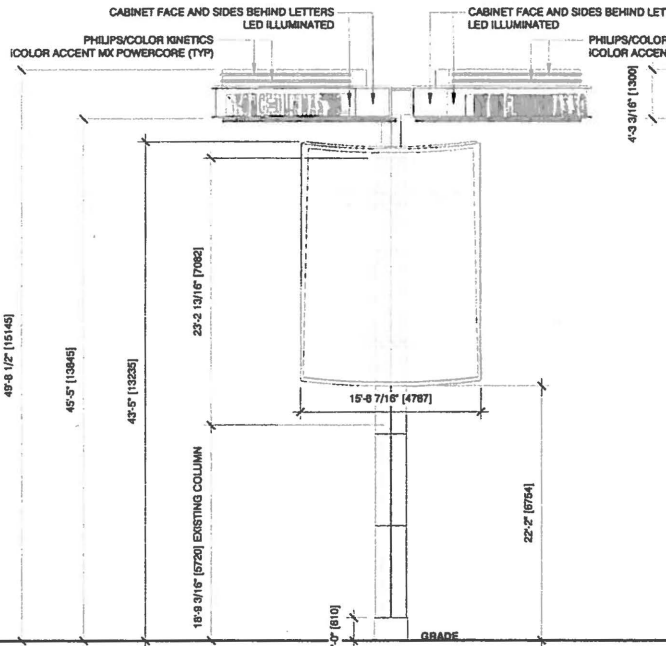

1 West Gateway - Elevations  
W2.1 Scale: 3/32" = 1'-0"

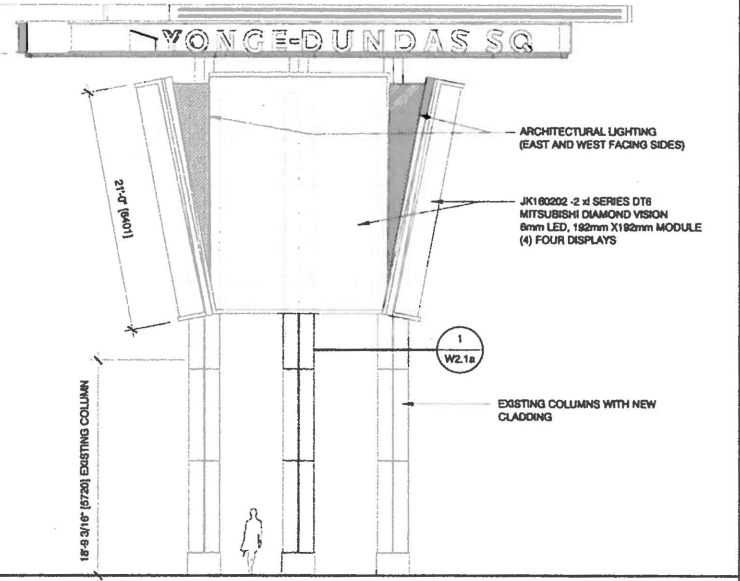

SIDE ELEVATION

**KDA**  
Kramer Tel: 416.921.1078  
Design Fax: 416.921.9934  
Associates www.kramer-design.com

CLIENT Yonge-Dundas Square

PROJECT Yonge-Dundas Square Revitalization

DATE Master Plan Submission November 3, 2016








TITLE Northwest Gateway

DWG No

APPROVAL

W2.1

These drawings are not to be scaled. The design and documents remain the property of KDA and are protected by law. They may not be altered, copied, or reproduced without expressed written consent from KDA. All documents to be returned to KDA at completion of work. Contractor to site verify all details and dimensions and report any and all discrepancies to KDA before commencing with that related portion of the work. Only signed, sealed and stamped documents are to be used for construction purposes.

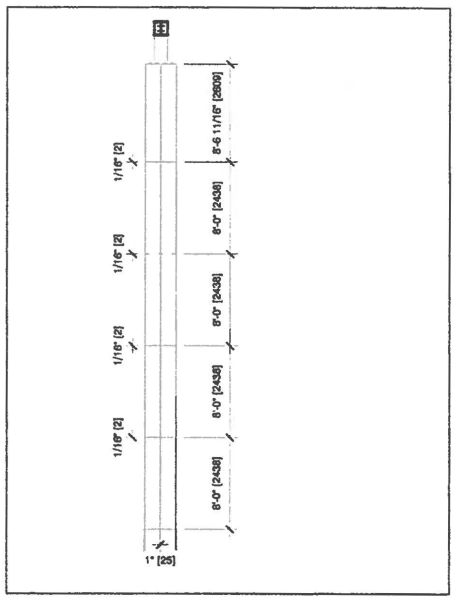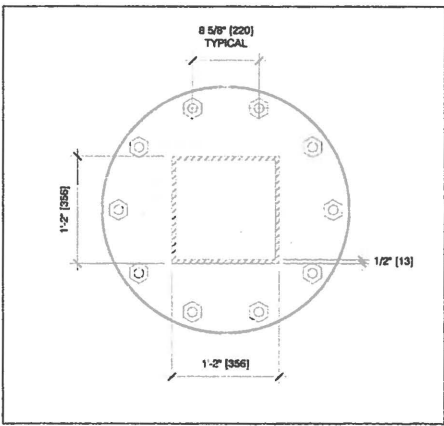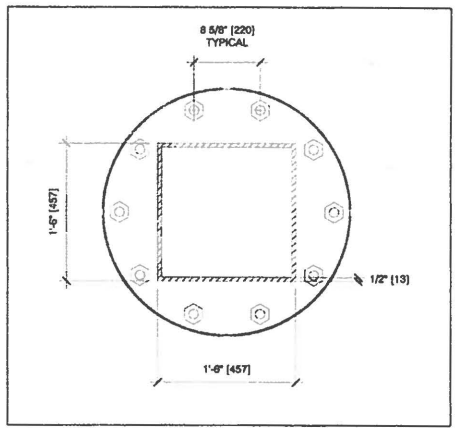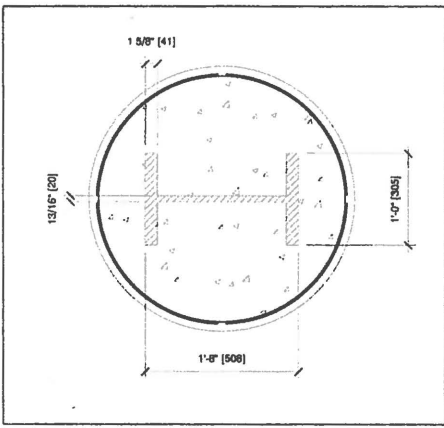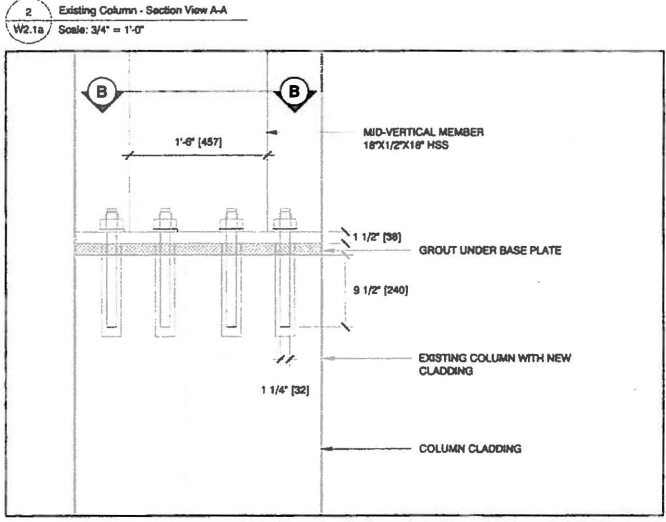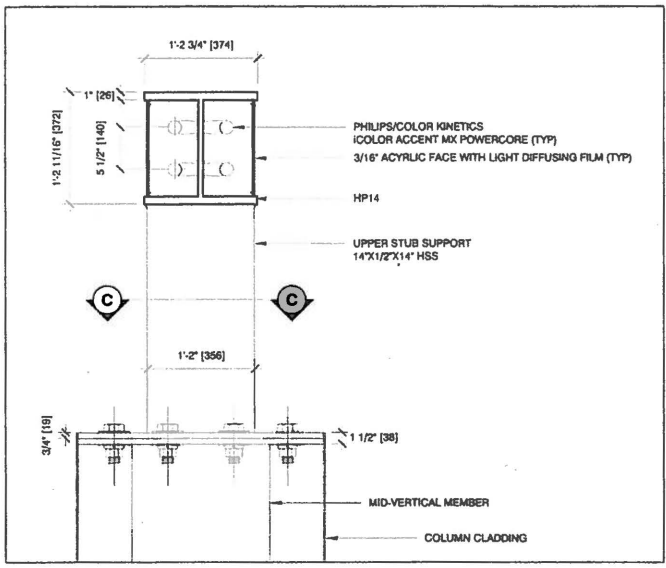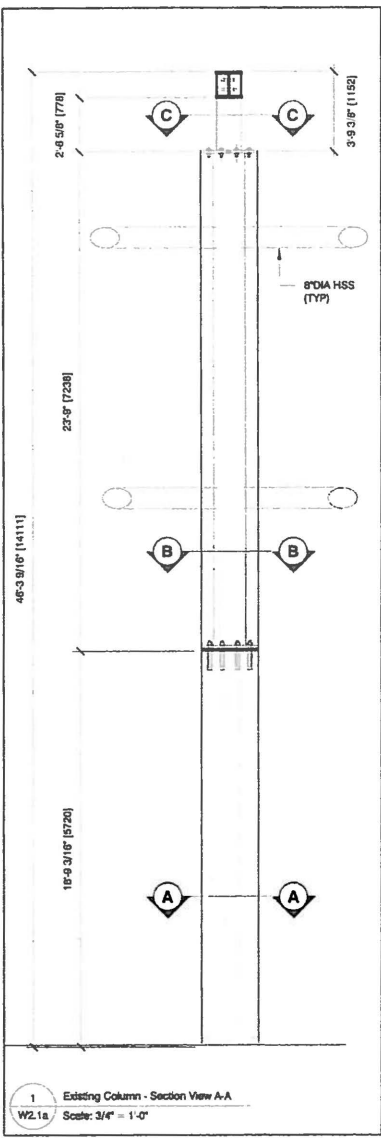


**KDA** Kramer Tel: 416.821.1078  
Design Fax: 416.821.8834  
Associates www.kramer-design.com

CLIENT Yonge-Dundas Square PROJECT Yonge-Dundas Square Revitalization  
DATE Master Plan Submission November 3, 2016  
TITLE Northwest Gateway Structural Support Details  
APPROVAL

These documents are not to be scaled. The design and documents remain the property of KDA and are provided by law. They may not be altered, copied, or reproduced without expressed written consent from KDA. All documents to be returned to KDA at completion of work. Contractor to site verify all details and dimensions and report any and all discrepancies to KDA before commencing with that related portion of the work. Only signed, sealed and stamped documents are to be used for construction purposes.


DWG No  
**W2.1a**

NOTE: ARTWORK FOR LIGHTING LAYOUT TO BE PROVIDED BY KDA IN ADOBE ILLUSTRATOR FORMAT

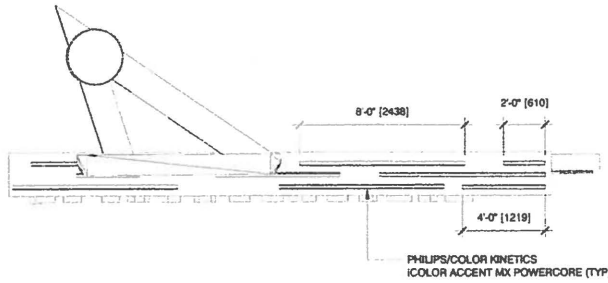

NOTE:

- ALL STRUCTURAL ELEMENTS ARE SUBJECT TO REVIEW AND APPROVAL AND ARE TO BE STAMPED BY A PROFESSIONAL ENGINEER LICENSED IN THE PROVINCE OF ONTARIO
- APPROPRIATE BARRIERS (NEOPRENE OR APPROVED EQUAL) TO PROVIDE BARRIER BETWEEN STEEL AND ALUMINUM ELEMENTS
- ALL STEEL IN CONFORMANCE WITH CSA G40.21 fy=300MPa MIN. STEEL TO BE HOT DIP GALVANIZED AND IF VISIBLE TO HAVE AAMA 2604 COMPLIANT POWDER COAT PAINTED FINISH UNLESS OTHERWISE SPECIFIED
- ALL ALUMINUM TO BE 6061-T6 (276MPa) WELDING TO CSA W47.2 W/ POWDER COAT PAINTED FINISH UNLESS OTHERWISE SPECIFIED
- NO VISIBLE FASTENERS
- ALL FASTENERS TO BE COUNTERSUNK STAINLESS STEEL UNLESS OTHERWISE SPECIFIED
- ALL STAINLESS STEEL TO BE GRADE 316

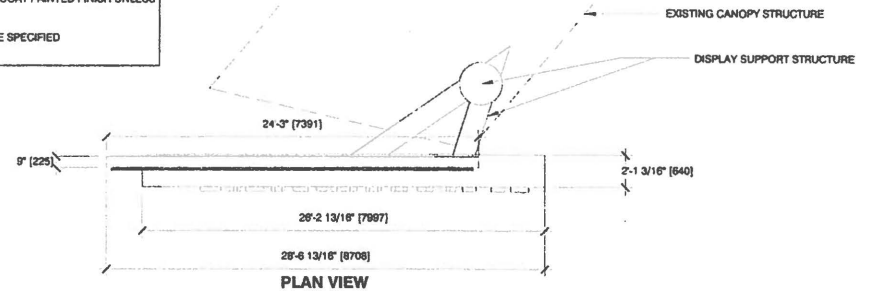


2 Bottom View  
W2.2 Scale: 3/32" = 1'-0"

Northeast Gateway Area


- Scale: NTS
- A - 16'-1" [4902]
  - B - 9'-10 5/16" [3005]
  - C - 2'-5 3/4" [756]
  - D - 28'-6 13/16" [8708]

AREA OF A&B: 14.7 m<sup>2</sup>  
AREA OF C&D: 6.6 m<sup>2</sup>


TOTAL AREA: 21.3 m<sup>2</sup>

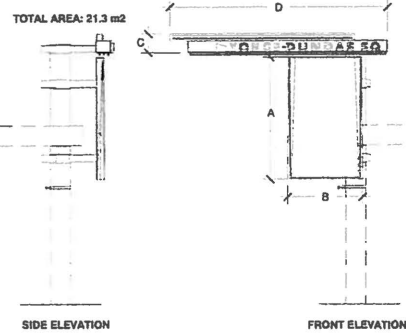

3 Northeast Gateway Area  
W2.2 Scale: 3/32" = 1'-0"

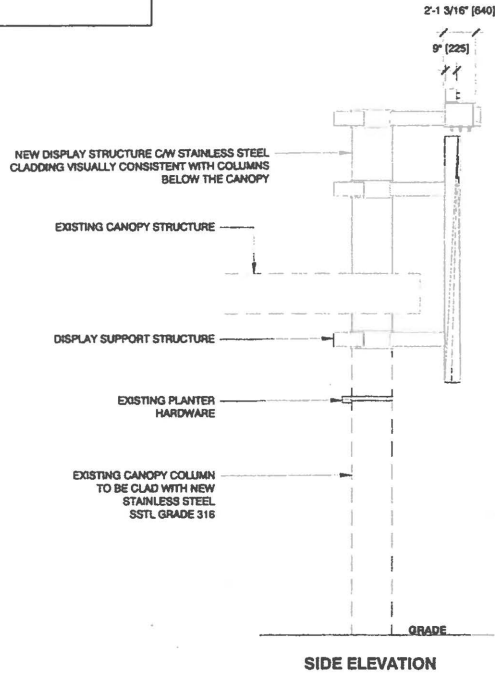

1 East Gateway - Elevations  
W2.2 Scale: 1/8" = 1'-0"

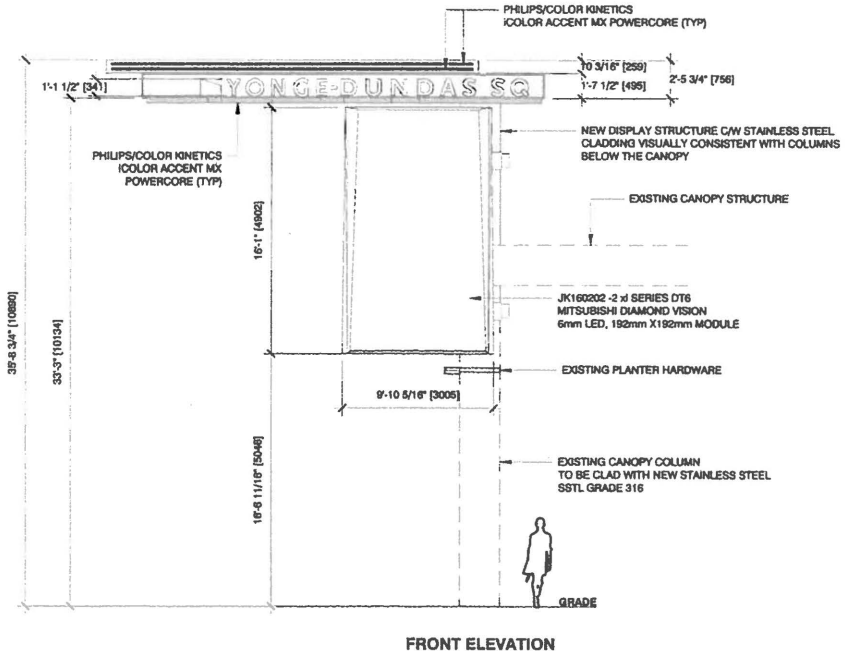

FRONT ELEVATION

**KDA**  
Kramer Tel: 416.921.1078  
Design Fax: 416.921.9934  
Associates www.kramer-design.com


CLIENT	Yonge-Dundas Square	PROJECT	Yonge-Dundas Square Revitalization	DATE	Master Plan Submission November 3, 2016	TITLE	Northeast Gateway	DWG No	W2.2
						APPROVAL			
<small>These documents are not to be sealed. The design and documents remain the property of KDA and are protected by law. They may not be altered, copied, or reproduced without expressed written consent from KDA. All documents to be returned to KDA in completion of work. Contractors to site verify all details and dimensions and report any and all discrepancies to KDA before commencing with that related portion of the work. Only signed, sealed and stamped documents are to be used for construction purposes.</small>									

**Stage Screen Left Area**

Scale: NTS

A - 9'-10 1/8" [3000]  
B - 19'-8 1/4" [6000]


TOTAL AREA: 18m<sup>2</sup>

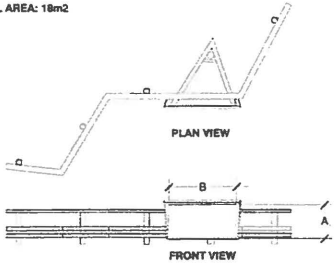


**NOTE:**

- ALL STRUCTURAL ELEMENTS ARE SUBJECT TO REVIEW AND APPROVAL AND ARE TO BE STAMPED BY A PROFESSIONAL ENGINEER LICENSED IN THE PROVINCE OF ONTARIO
- APPROPRIATE BARRIERS (NEOPRENE OR APPROVED EQUAL) TO PROVIDE BARRIER BETWEEN STEEL AND ALUMINUM ELEMENTS
- ALL STEEL IN CONFORMANCE WITH CSA G40.21 (y = 300MPa) MIN. STEEL TO BE HOT DIP GALVANIZED AND IF VISIBLE TO HAVE AAMA 2604 COMPLIANT POWDER COAT PAINTED FINISH UNLESS OTHERWISE SPECIFIED
- ALL ALUMINUM TO BE 6061 T6 [276MPa] WELDING TO CSA W47.2 W/ POWDER COAT PAINTED FINISH UNLESS OTHERWISE SPECIFIED
- NO VISIBLE FASTENERS
- ALL FASTENERS TO BE COUNTERSUNK STAINLESS STEEL UNLESS OTHERWISE SPECIFIED
- ALL STAINLESS STEEL TO BE GRADE 316

**2 Stage Screen Left Area**  
W2.3 Scale: NTS

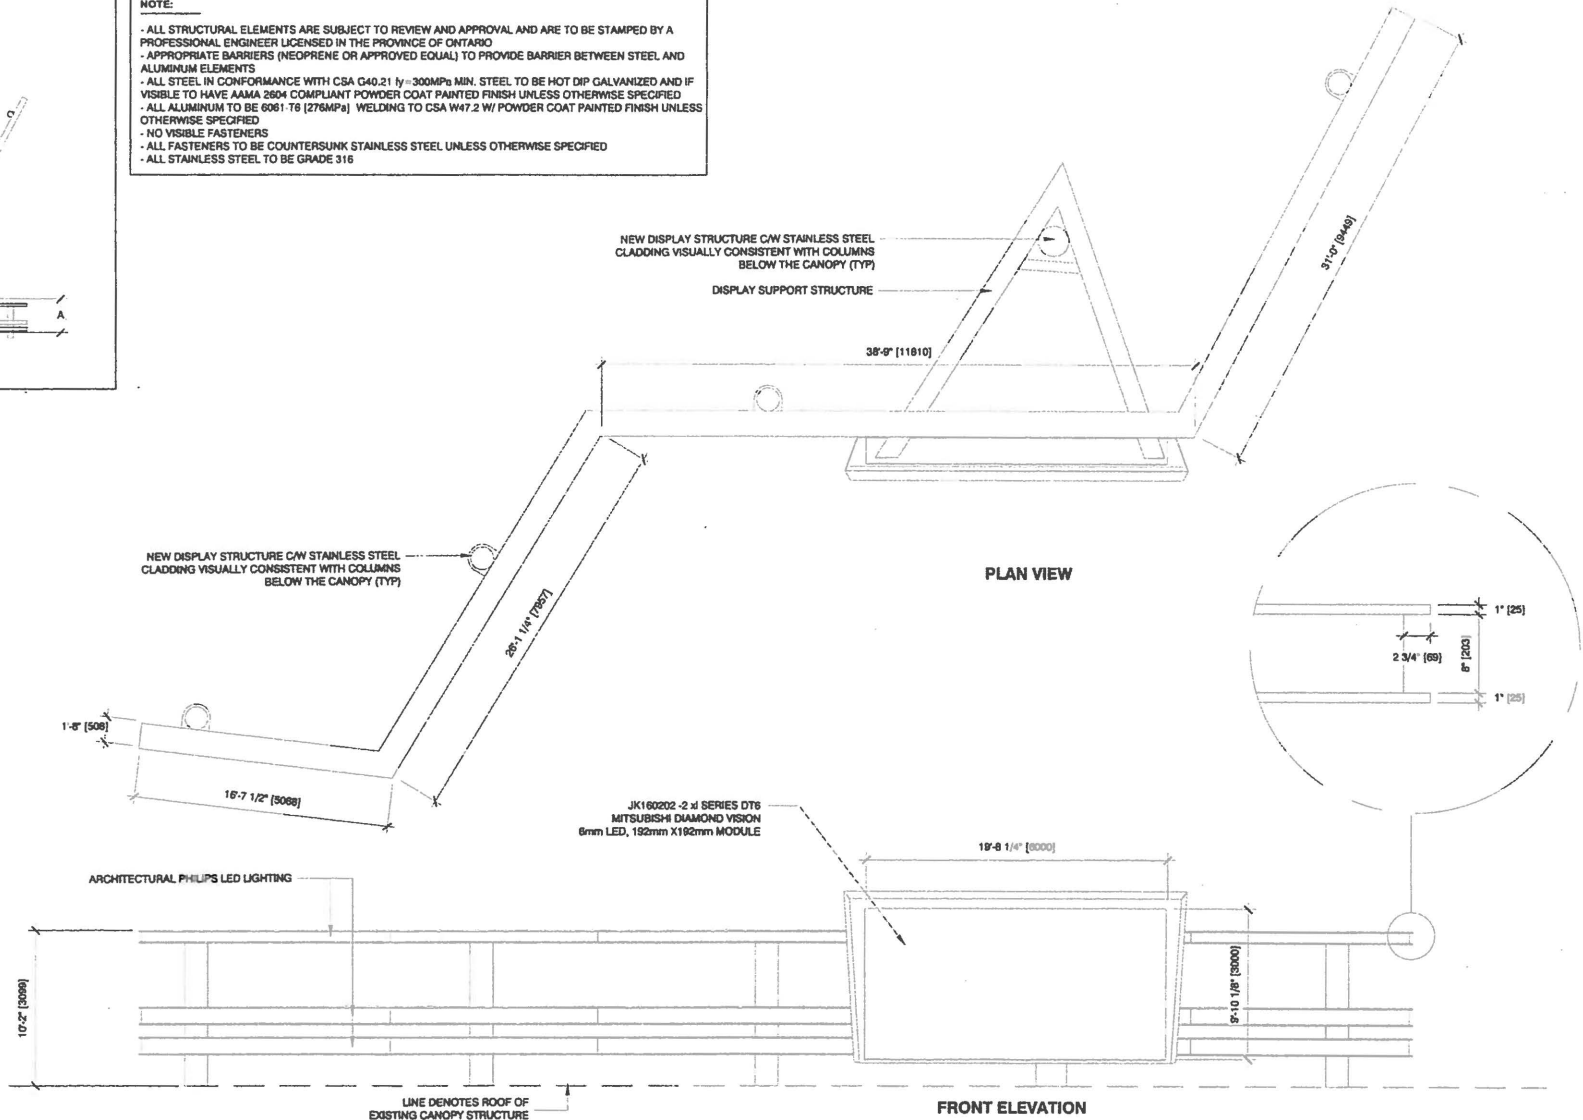

**1 Above Canopy Display - Elevations**  
W2.3 Scale: 1/8" = 1'-0"


 Kremer Tel: 416.921.1078 Design Fax: 416.921.9934 Associates www.kremer-design.com	CLIENT	Yonge-Dundas Square	PROJECT	Yonge-Dundas Square Revitalization	DATE	Master Plan Submission November 3, 2016	TITLE	Stage Screen Left (Above Canopy Display)	DWG No
	APPROVAL								W2.3
	These documents are not to be scaled. This design and documents remain the property of KDA and are protected by law. They may not be altered, loaned, or reproduced without expressed written consent from KDA. All documents to be returned to KDA at completion of work. Contractor to verify all details and dimensions and report any and all discrepancies to KDA before commencing with that related portion of the work. Only original, sealed and stamped documents are to be used for construction purposes.								

**Stage Screen Right Area**

Scale: NTS


A - 9'-10 1/8" [3000]  
B - 19'-8 1/4" [6000]

TOTAL AREA: 18m<sup>2</sup>

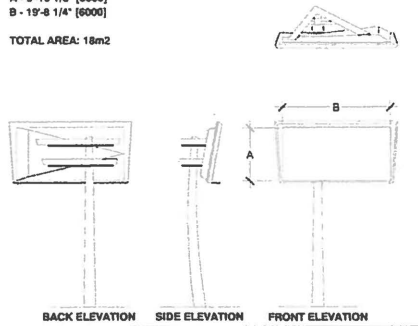


**NOTE:**

- ALL STRUCTURAL ELEMENTS ARE SUBJECT TO REVIEW AND APPROVAL AND ARE TO BE STAMPED BY A PROFESSIONAL ENGINEER LICENSED IN THE PROVINCE OF ONTARIO
- APPROPRIATE BARRIERS (NEOPRENE OR APPROVED EQUAL) TO PROVIDE BARRIER BETWEEN STEEL AND ALUMINUM ELEMENTS
- ALL STEEL IN CONFORMANCE WITH CSA G40.21 fy=300MPa MIN. STEEL TO BE HOT DIP GALVANIZED AND IF VISIBLE TO HAVE AAMA 2604 COMPLIANT POWDER COAT PAINTED FINISH UNLESS OTHERWISE SPECIFIED
- ALL ALUMINUM TO BE 6061 T6 [276MPa] WELDING TO CSA W47.2 W/ POWDER COAT PAINTED FINISH UNLESS OTHERWISE SPECIFIED
- NO VISIBLE FASTENERS
- ALL FASTENERS TO BE COUNTERSUNK STAINLESS STEEL UNLESS OTHERWISE SPECIFIED
- ALL STAINLESS STEEL TO BE GRADE 316

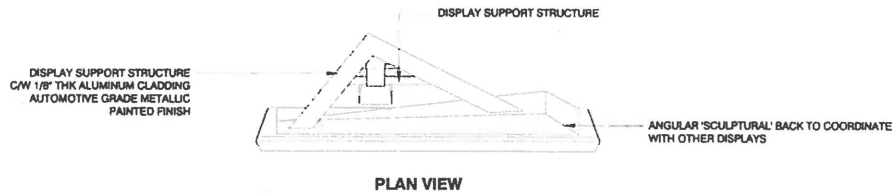

PLAN VIEW

2 Stage Screen Right Area  
W2.3 Scale: NTS

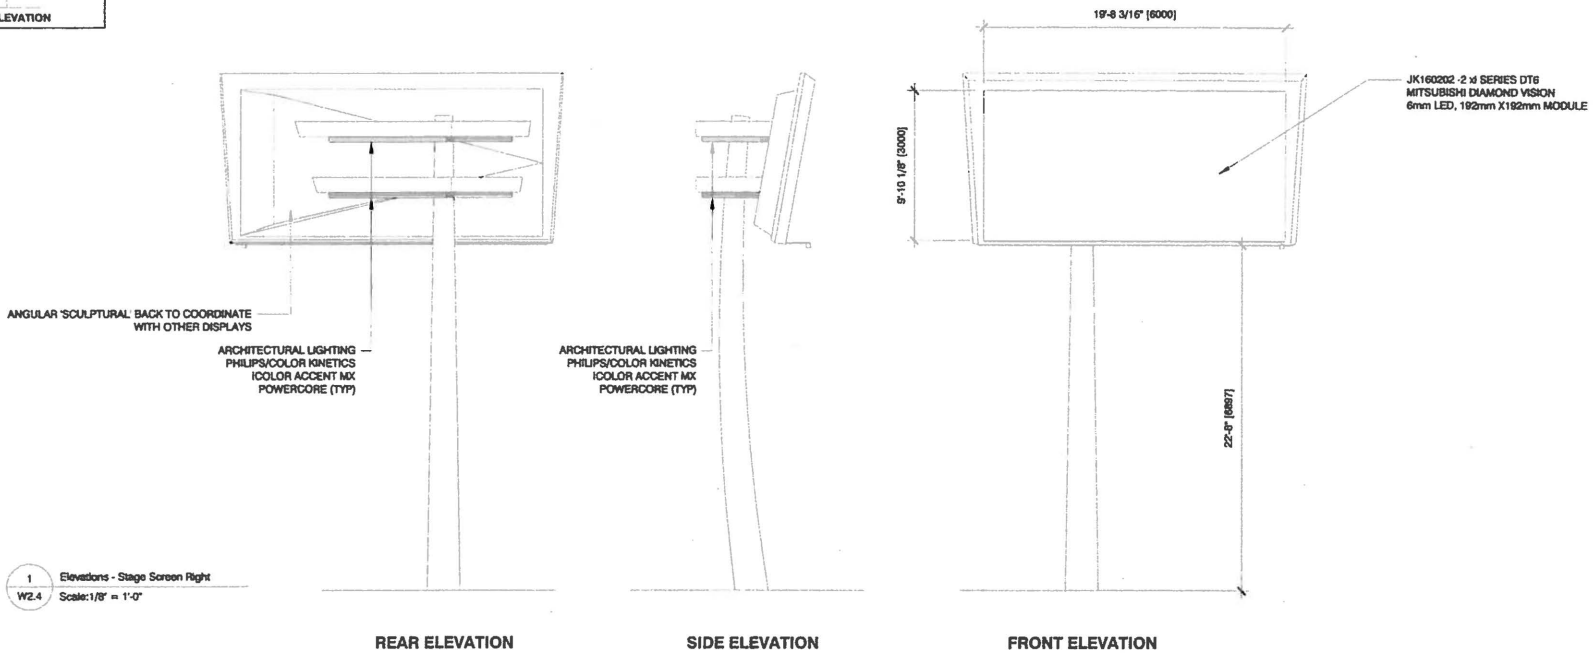


1 Elevations - Stage Screen Right  
W2.4 Scale: 1/8" = 1'-0"

REAR ELEVATION

SIDE ELEVATION

FRONT ELEVATION

 Kramer Tel: 416.921.1078 Design Fax: 416.921.9934 Associates www.kramer-design.com	CLIENT	Yonge-Dundas Square	PROJECT	Yonge-Dundas Square Revitalization	DATE	Master Plan Submission	November 3, 2016	TITLE	Stage Screen Right	DWG No	<p style="font-size: 2em; font-weight: bold;">W2.4</p>
	These documents are not to be scaled. This design and documents remain the property of KDA and are protected by law. They may not be altered, copied, or reproduced without expressed written consent from KDA. All documents to be related to KDA at completion of work. Contractor to site verify all details and dimensions and report any and all discrepancies to KDA before commencing with that related portion of the work. Only signed, sealed and stamped documents are to be used for construction purposes.								APPROVAL		



**Digital Light Poles**


Scale: NTS

A - 13'-11-3/16" [4248]  
B - 7'-11-7/8" [2438]

Total Area: 10.34m<sup>2</sup>




PLAN VIEW

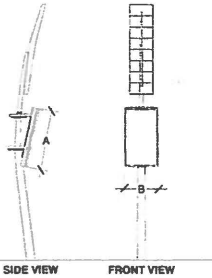

SIDE VIEW FRONT VIEW


2 Area  
W2.5 Scale: NTS

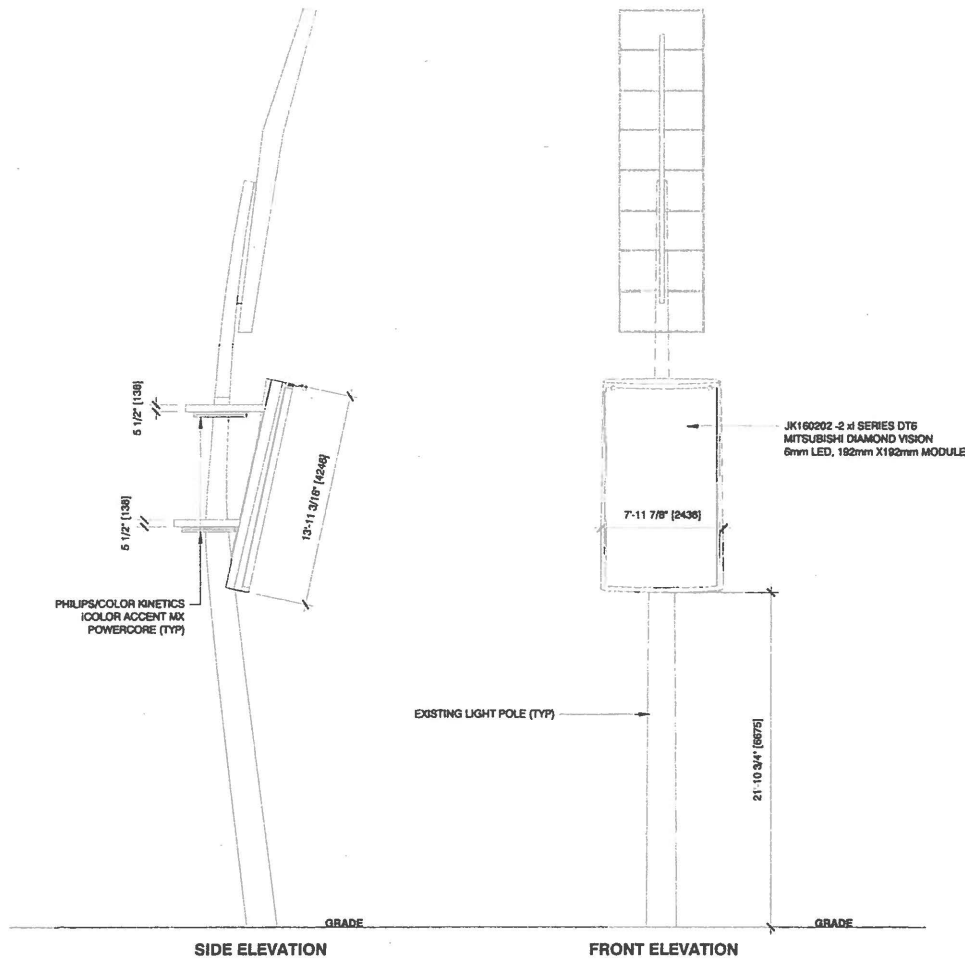

1 Elevations - Digital Light Poles  
W2.5 Scale: 1/8" = 1'-0"

**NOTE:**

- ALL STRUCTURAL ELEMENTS ARE SUBJECT TO REVIEW AND APPROVAL AND ARE TO BE STAMPED BY A PROFESSIONAL ENGINEER LICENSED IN THE PROVINCE OF ONTARIO
- APPROPRIATE BARRIERS (NEOPRENE OR APPROVED EQUAL) TO PROVIDE BARRIER BETWEEN STEEL AND ALUMINUM ELEMENTS
- ALL STEEL IN CONFORMANCE WITH CSA G40.21 fy=360MPa MIN. STEEL TO BE HOT DIP GALVANIZED AND IF VISIBLE TO HAVE AAMA 2604 COMPLIANT POWDER COAT PAINTED FINISH UNLESS OTHERWISE SPECIFIED
- ALL ALUMINUM TO BE 6061-T6 [276MPa] WELDING TO CSA W47.2 W/ POWDER COAT PAINTED FINISH UNLESS OTHERWISE SPECIFIED
- NO VISIBLE FASTENERS
- ALL FASTENERS TO BE COUNTERSUNK STAINLESS STEEL UNLESS OTHERWISE SPECIFIED
- ALL STAINLESS STEEL TO BE GRADE 316

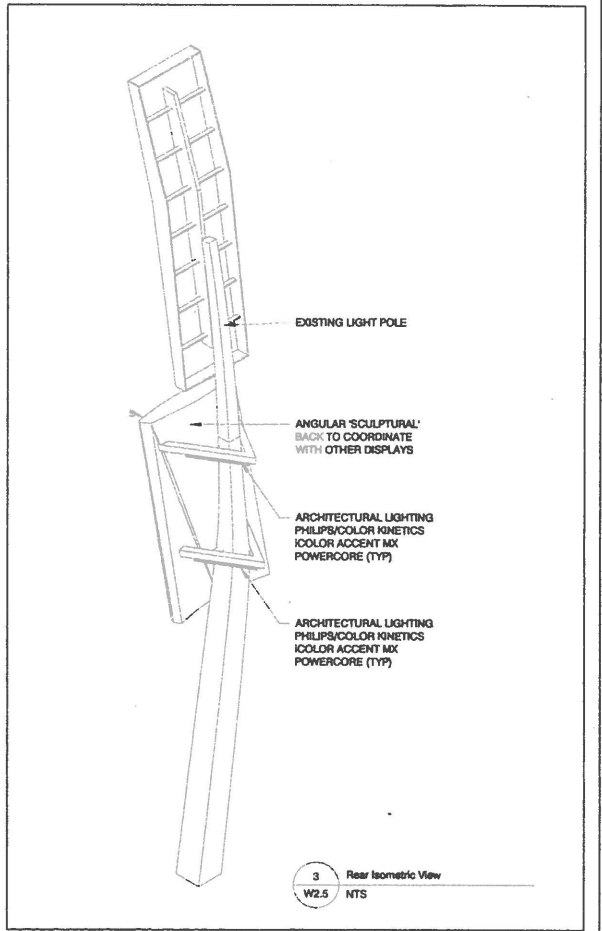

3 Rear Isometric View  
W2.5 NTS

<p>Kramer Tel: 416.921.1078 Design Fax: 416.921.9934 Associates www.kramer-design.com</p>	CLIENT	Yonge-Dundas Square	PROJECT	Yonge-Dundas Square Revitalization	DATE	Master Plan Submission November 3, 2016	TITLE	Digital Light Poles	DWG No	
									APPROVAL	W2.5
	<small>These documents are not to be scaled. The design and documents remain the property of KDA and are protected by law. They may not be altered, reused, or reproduced without expressed written consent from KDA. All documents to be returned to KDA at completion of work. Contractor to site verify all details and dimensions and report any and all discrepancies to KDA before commencing with that related portion of the work. Only signed, sealed and stamped dimensions are to be used for construction purposes.</small>									